


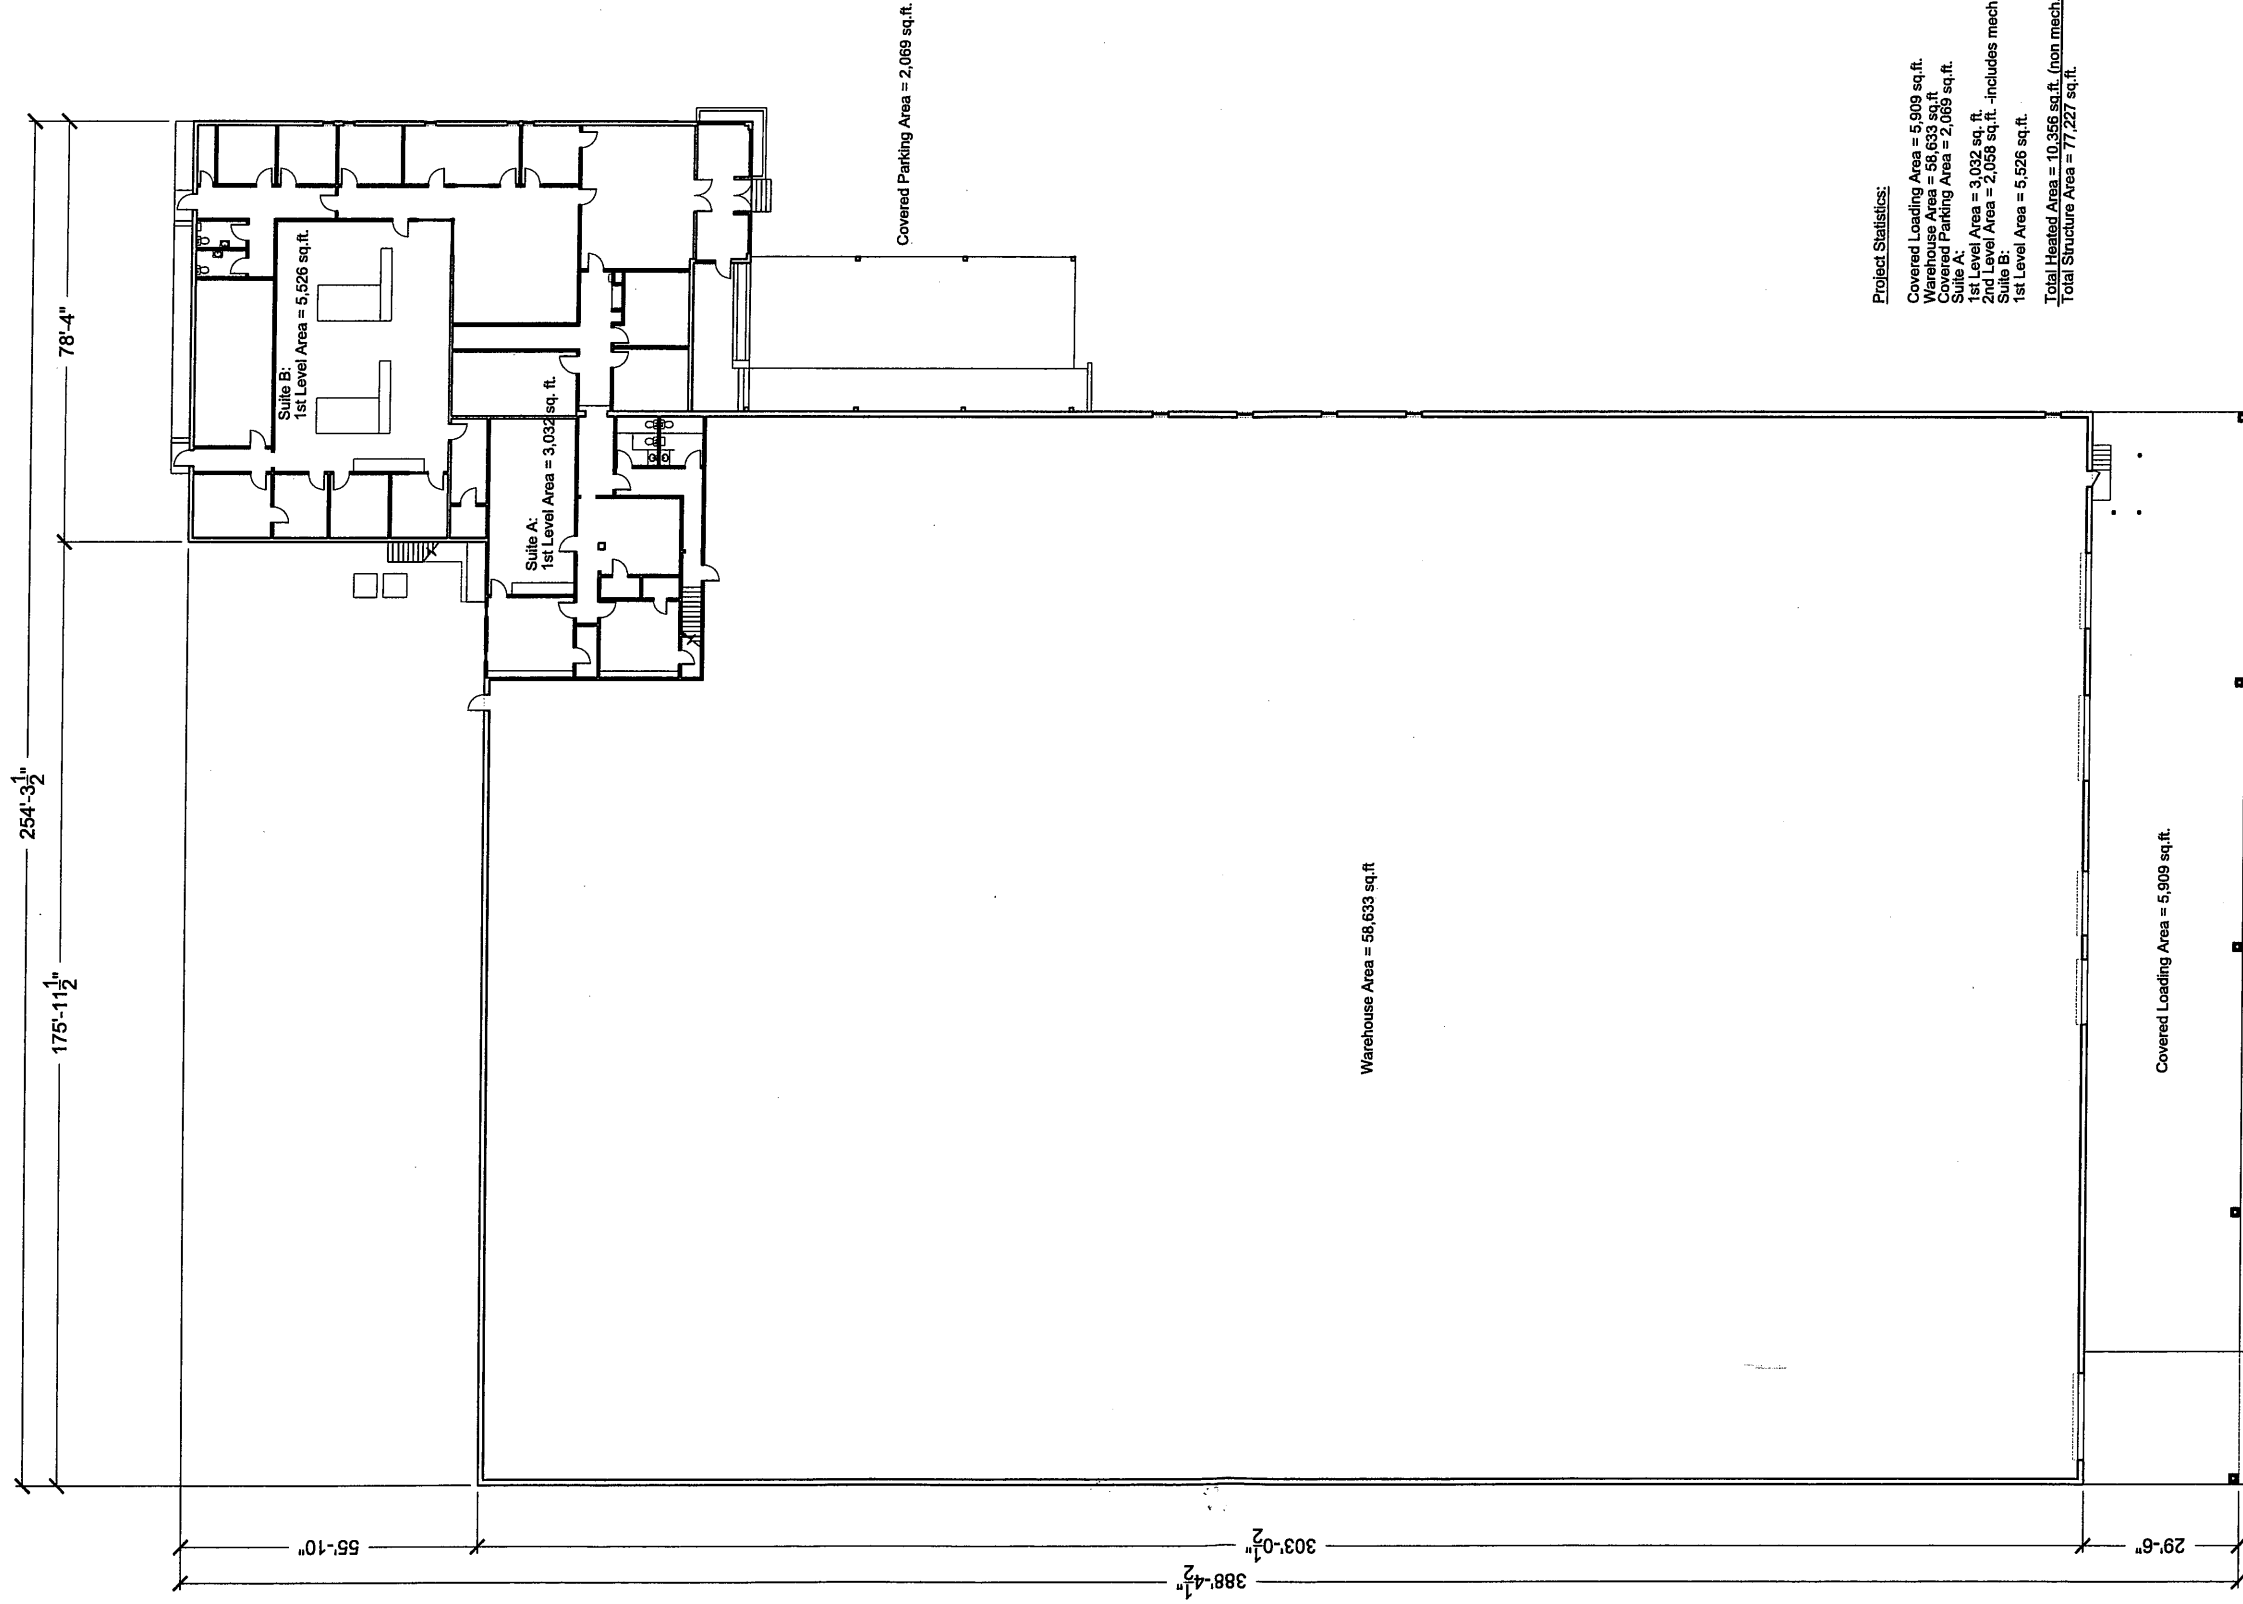

Project Statistics:
Covered Loading Area = 5,909 sq. ft.
Warehouse Area = 58,633 sq. ft.
Covered Parking Area = 2,069 sq. ft.
Suite A:
1st Level Area = 3,032 sq. ft.
2nd Level Area = 2,058 sq. ft. - includes mech.
Suite B:
1st Level Area = 5,526 sq. ft.
Total Heated Area = 10,356 sq. ft. (non mech.)
Total Structure Area = 77,227 sq. ft.

Composite Floor Plan

Scale: 1/16"=1'-0"



A-1

SHEET NUMBER

As-Built Construction Drawings

3735 Airline Highway - Reserve, La 70084

PROJECT TITLE

PROJECT NO.

1041

PROJECT DATE

07/07/2010

PROJECT DETAILS


HollingsworthDesign
www.hollingsworthdesign.net

tel. 504.247.3006
fax 985.307.0172

Project Statistics:

Covered Loading Area = 5,909 sq.ft.
Warehouse Area = 58,633 sq.ft.
Covered Parking Area = 2,069 sq.ft.
Suite A:
1st Level Area = 3,032 sq. ft.
2nd Level Area = 2,058 sq.ft. -includes mech.
Suite B:
1st Level Area = 5,526 sq.ft.

Total Heated Area = 10,356 sq.ft. (non mech.)
Total Structure Area = 77,227 sq.ft.

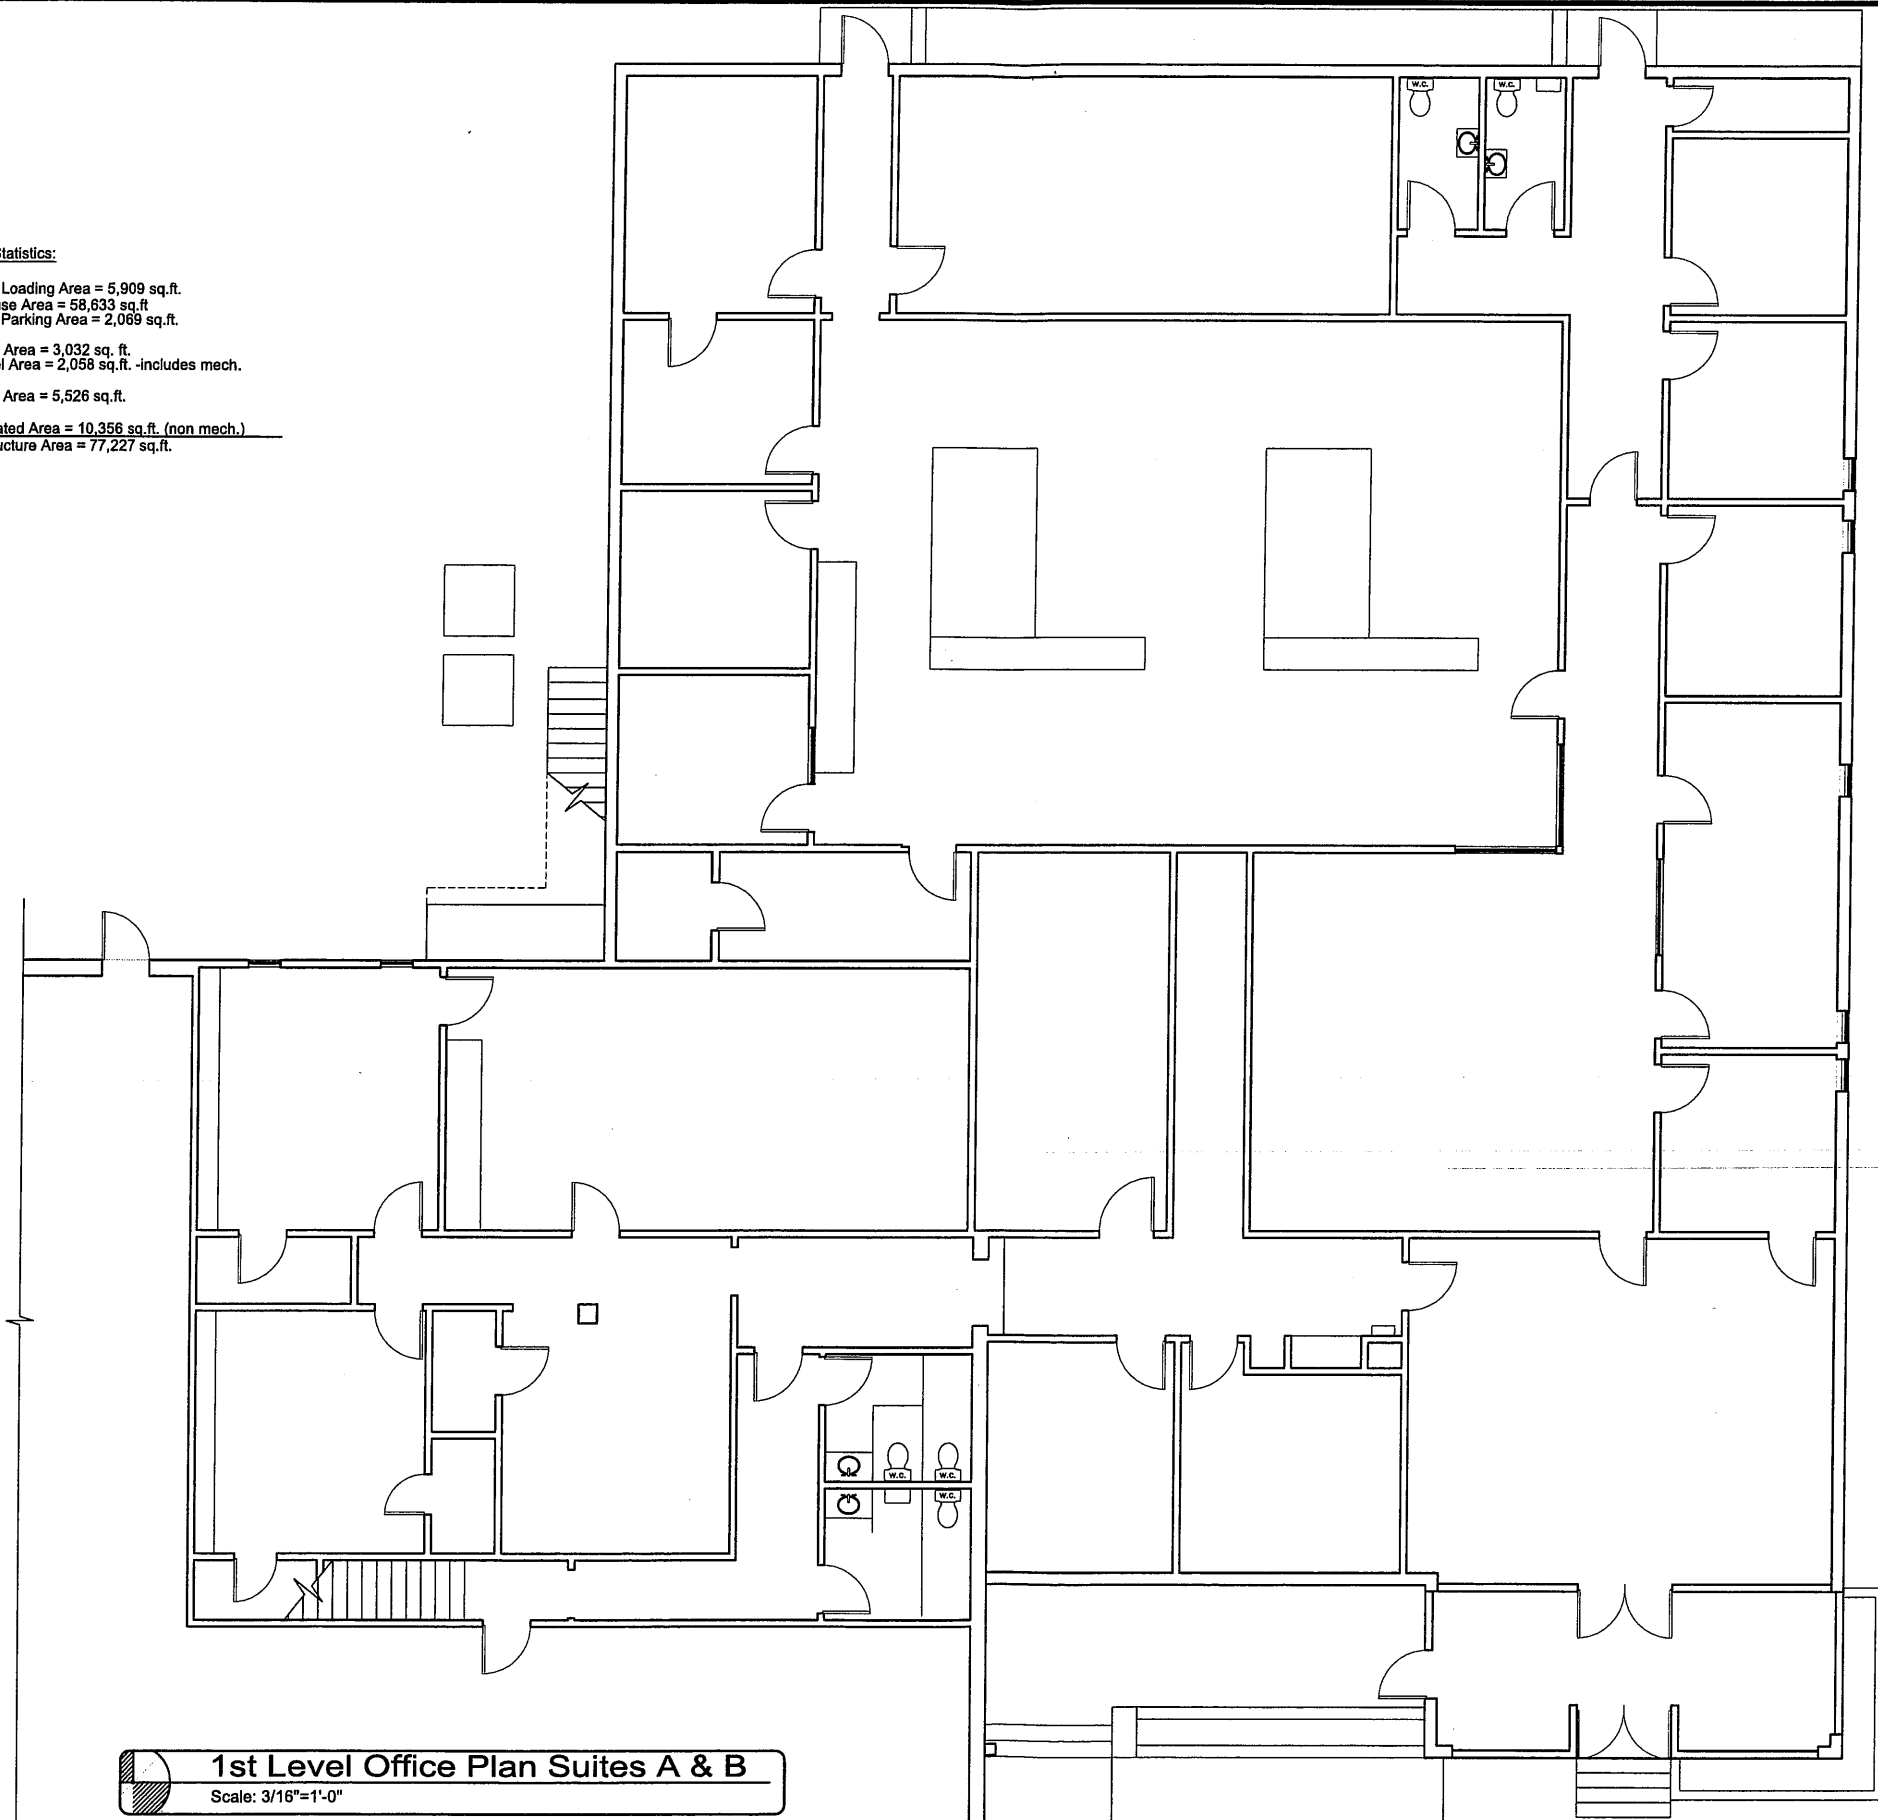

1st Level Office Plan Suites A & B
Scale: 3/16"=1'-0"



As-Built Construction Drawings
3735 Airline Highway - Reserve, La 70084

A-2
SHEET NUMBER

PROJECT NO.
1041

PROJECT DATE
07.07.2010

PROJECT DETAILS


Hollingsworth Design
www.hollingsworthdesign.net

tel. 504.247.3005
fax 986.307.0172

Project Statistics:

Covered Loading Area = 5,909 sq.ft.
Warehouse Area = 58,633 sq.ft.
Covered Parking Area = 2,069 sq.ft.
Suite A:
1st Level Area = 3,032 sq. ft.
2nd Level Area = 2,058 sq.ft. -includes mech.
Suite B:
1st Level Area = 5,526 sq.ft.

Total Heated Area = 10,356 sq.ft. (non mech.)
Total Structure Area = 77,227 sq.ft.

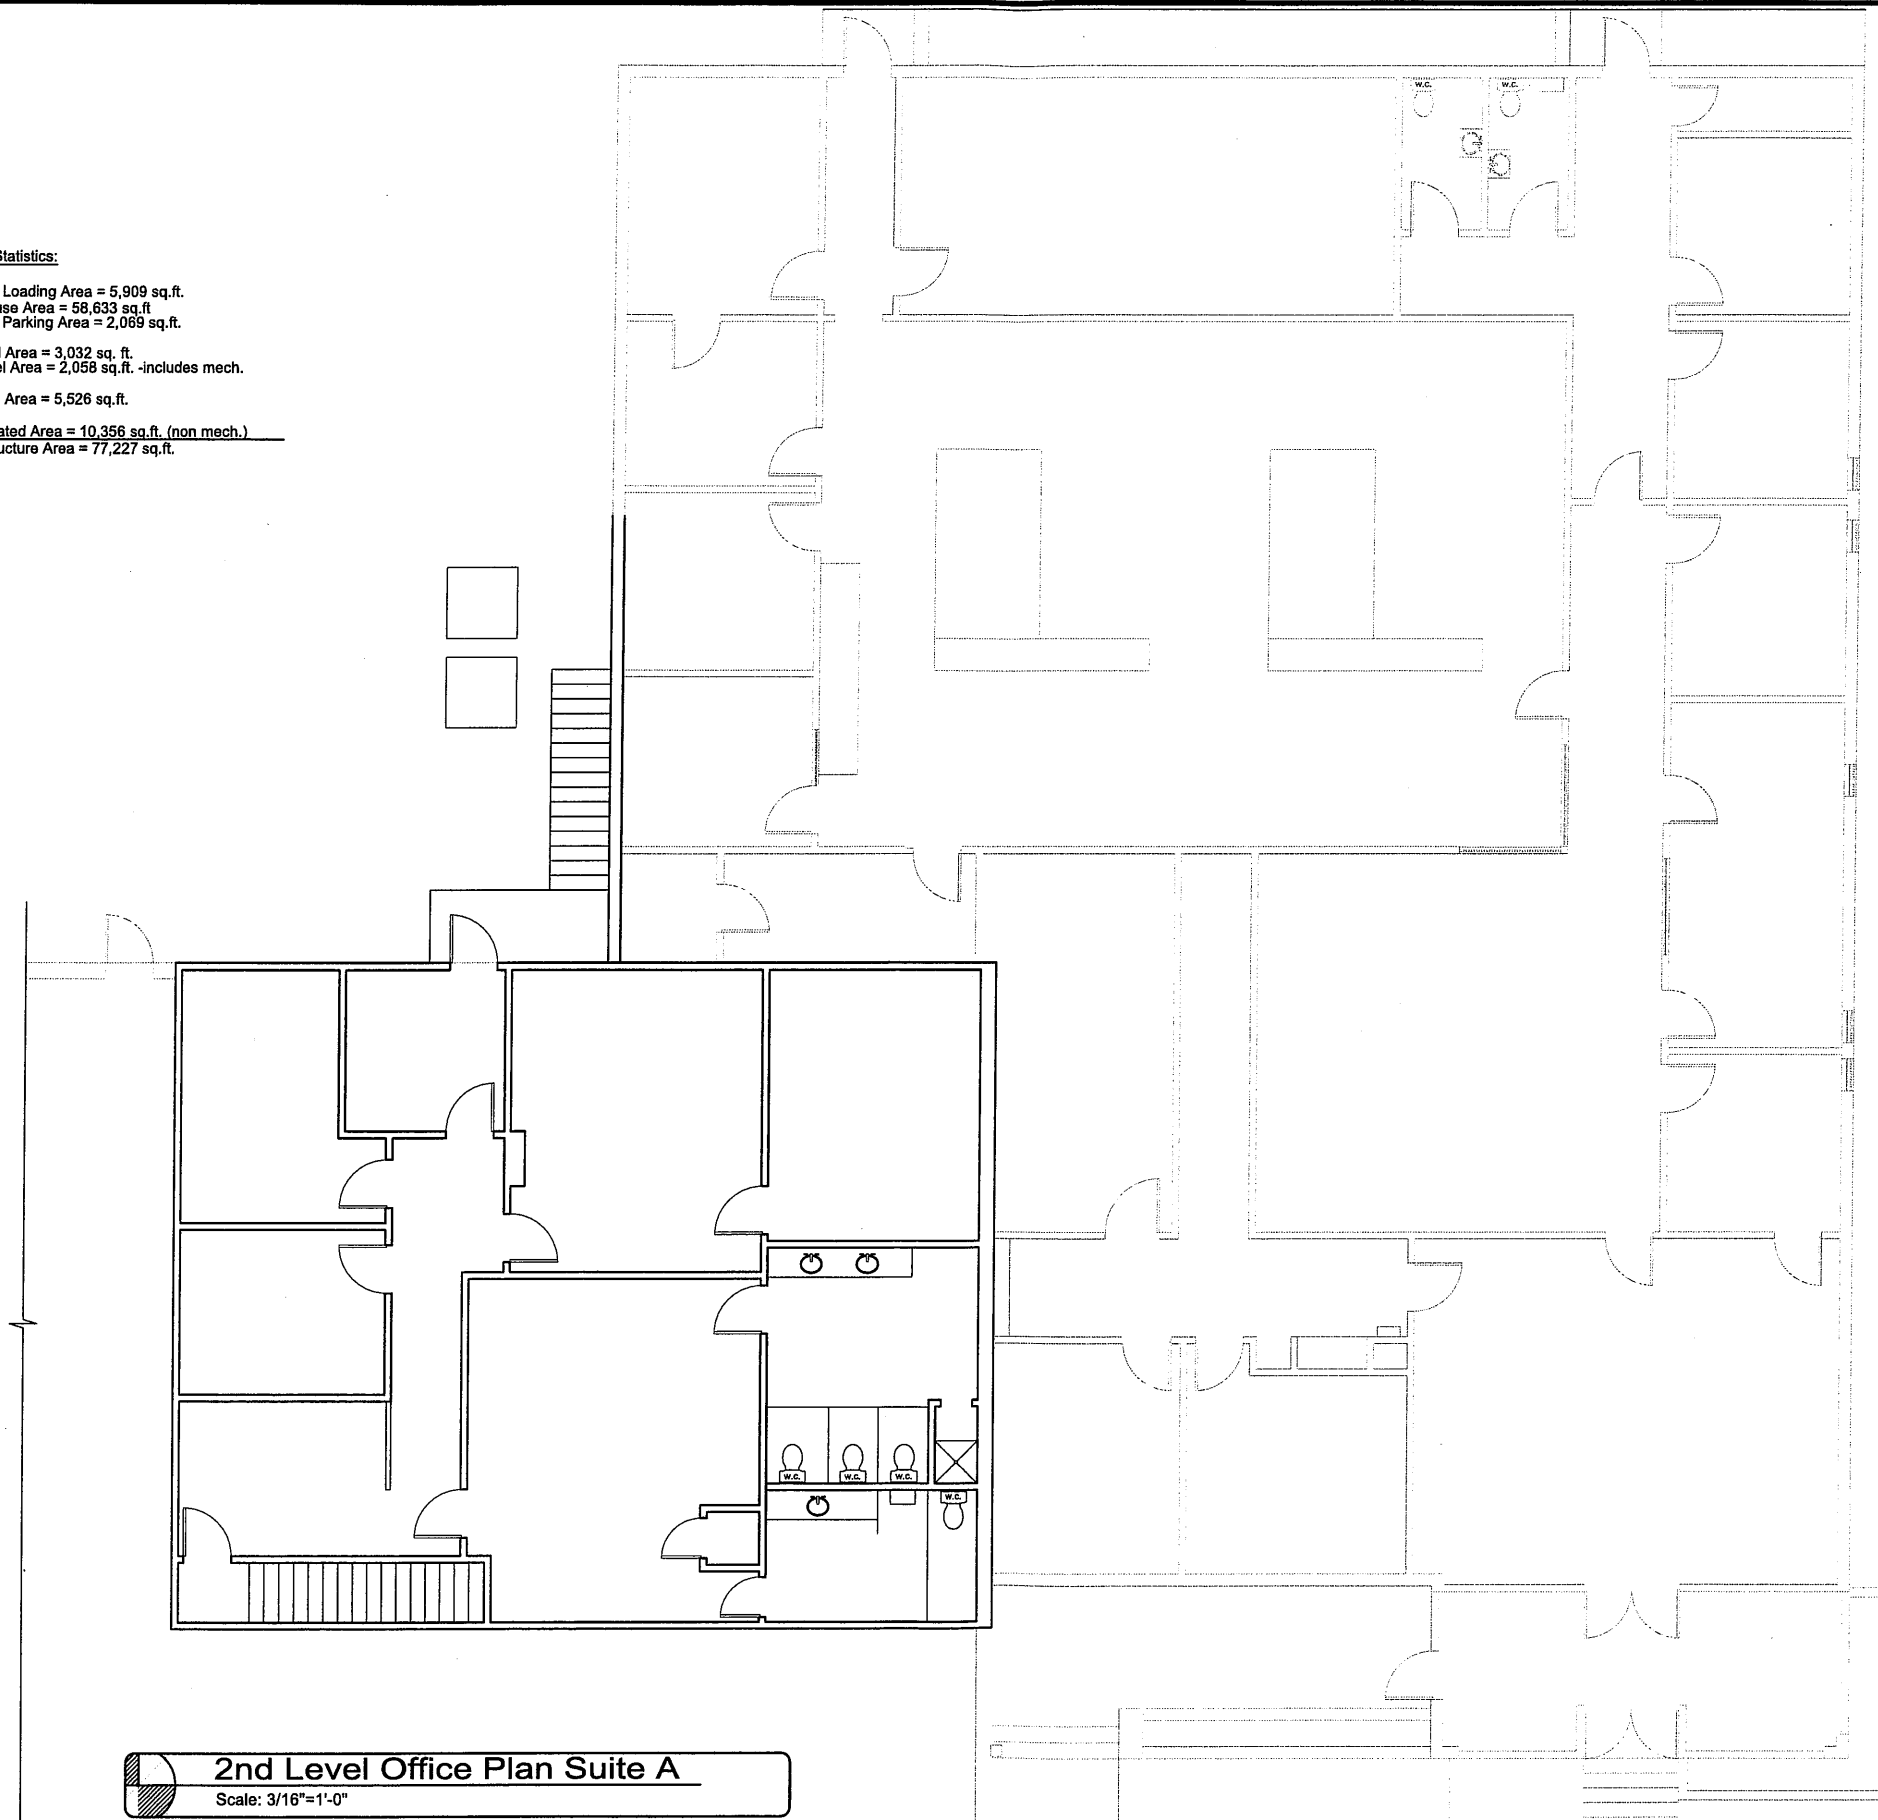

2nd Level Office Plan Suite A

Scale: 3/16"=1'-0"



As-Built Construction Drawings
3735 Airline Highway - Reserve, La 70084

A-3

SHEET NUMBER

PROJECT NO.
1041

PROJECT DATE
07.07.2010

PROJECT DETAILS

HollingsworthDesign
www.hollingsworthdesign.net
tel. 504.247.3006
fax 985.307.0172