


Project Statistics:

Covered Loading Area = 5,909 sq.ft.
Warehouse Area = 58,633 sq.ft.
Covered Parking Area = 2,069 sq.ft.
Suite A:
1st Level Area = 3,032 sq. ft.
2nd Level Area = 2,058 sq.ft. -includes mech.
Suite B:
1st Level Area = 5,526 sq.ft.
Total Heated Area = 10,356 sq.ft. (non mech.)
Total Structure Area = 77,227 sq.ft.

1st Level Office Plan Suites A & B
Scale: 3/16"=1'-0"

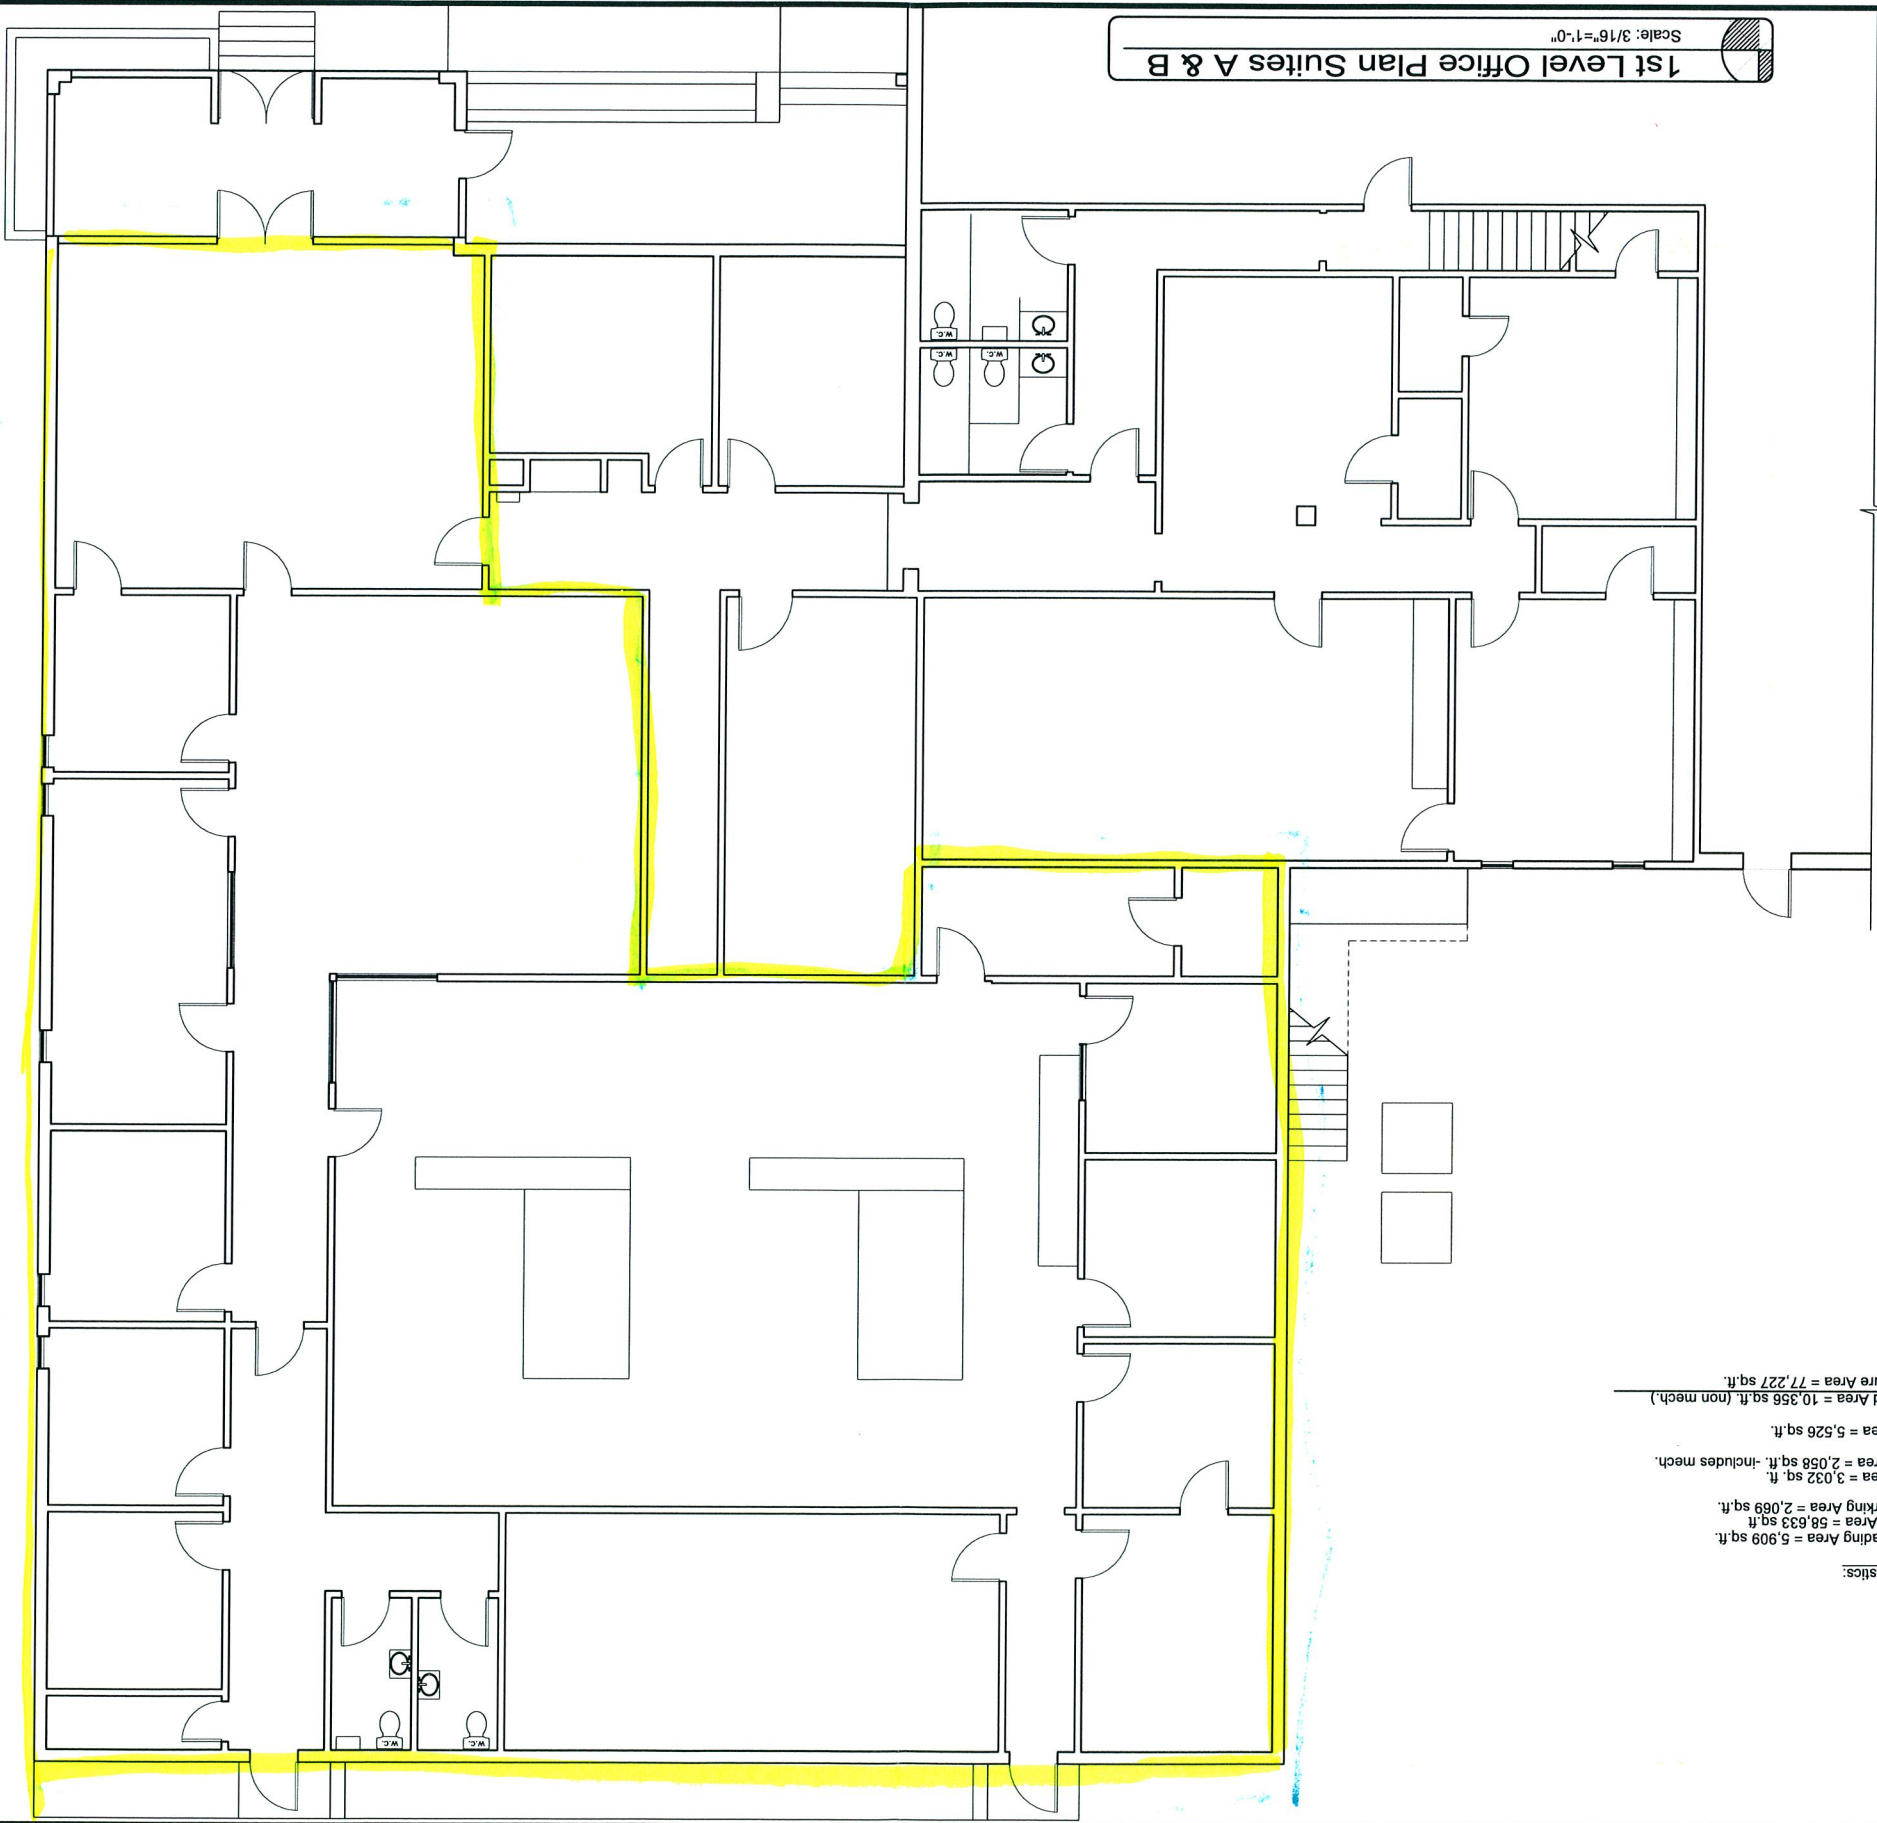

A-2
SHEET NUMBER

As-Built Construction Drawings
3735 Airline Highway - Reserve, La 70084
PROJECT TITLE


PROJECT NO. 1041
PROJECT DATE 07/07/2010
PROJECT DETAILS

HollingsworthDesign
www.hollingsworthdesign.net
tel. 504.247.3006
fax 985.307.0172

Project Statistics:

Covered Loading Area = 5,909 sq.ft.
Warehouse Area = 58,633 sq.ft.
Covered Parking Area = 2,069 sq.ft.
Suite A:
1st Level Area = 3,032 sq. ft.
2nd Level Area = 2,058 sq.ft. -includes mech.
Suite B:
1st Level Area = 5,526 sq.ft.
Total Heated Area = 10,356 sq.ft. (non mech.)
Total Structure Area = 77,227 sq.ft.

1st Level Office Plan Suites A & B
Scale: 3/16"=1'-0"

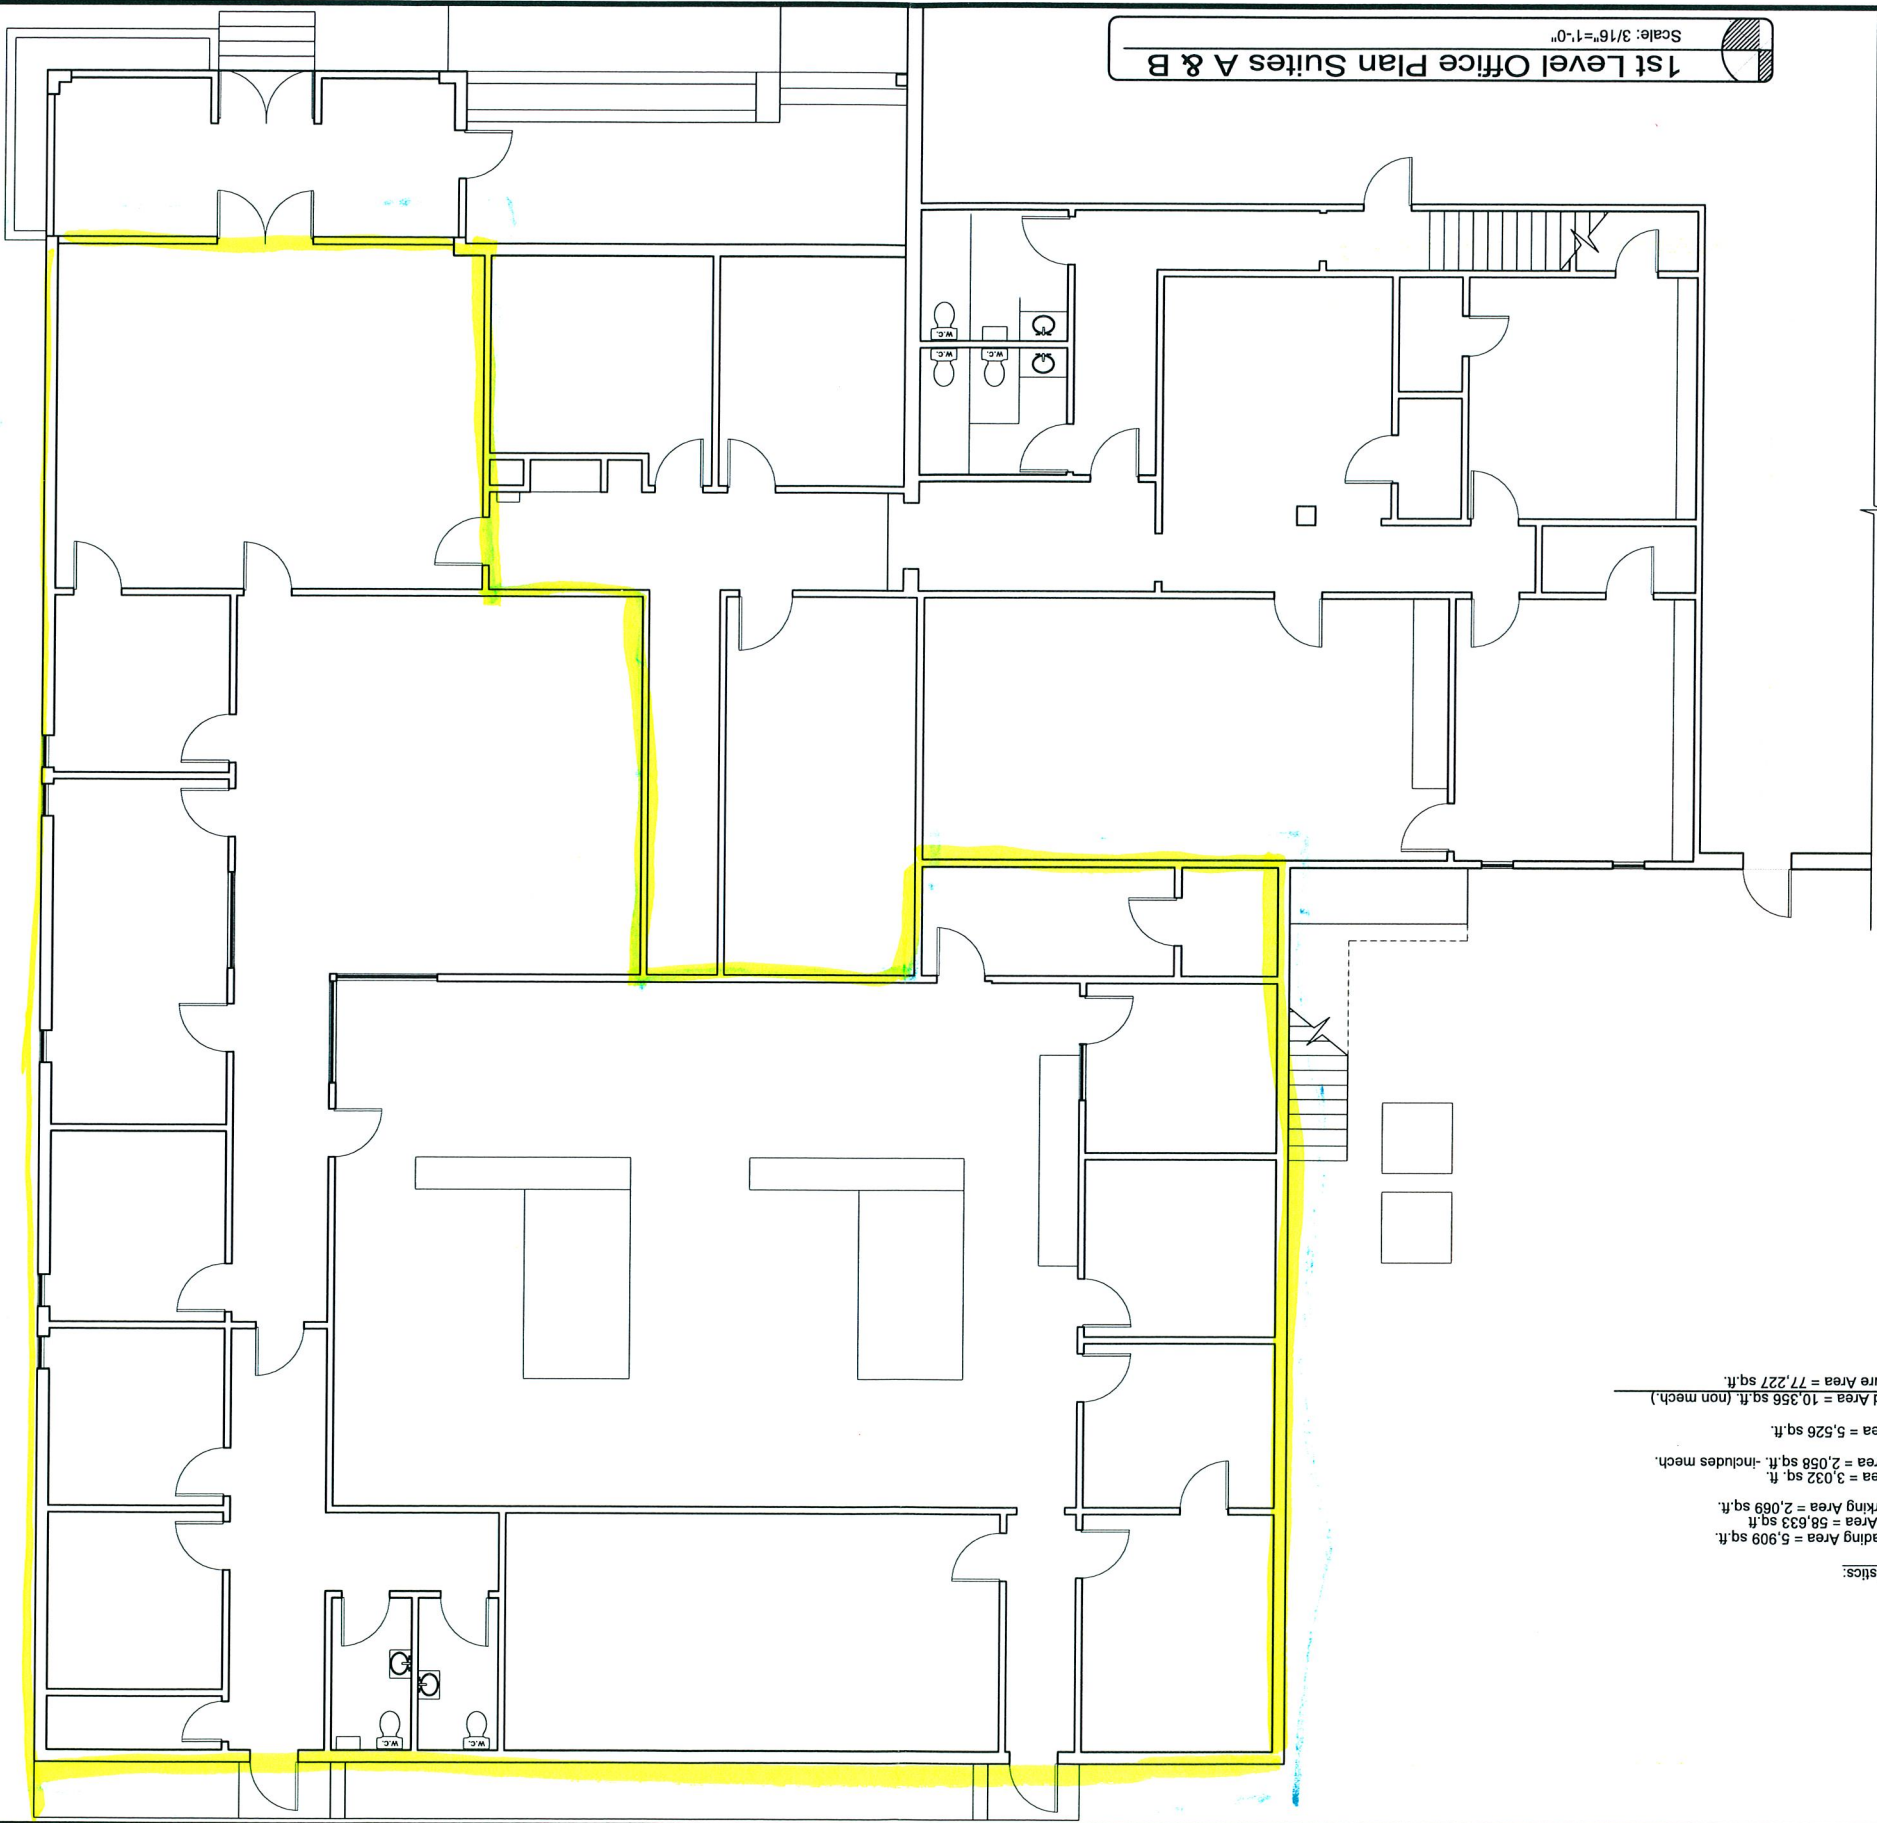

A-2
SHEET NUMBER

As-Built Construction Drawings
3735 Airline Highway - Reserve, La 70084
PROJECT TITLE

PROJECT NO. 1041
PROJECT DATE 07/07/2010
PROJECT DETAILS

HollingsworthDesign
www.hollingsworthdesign.net
tel. 504.247.3006
fax 985.307.0172